
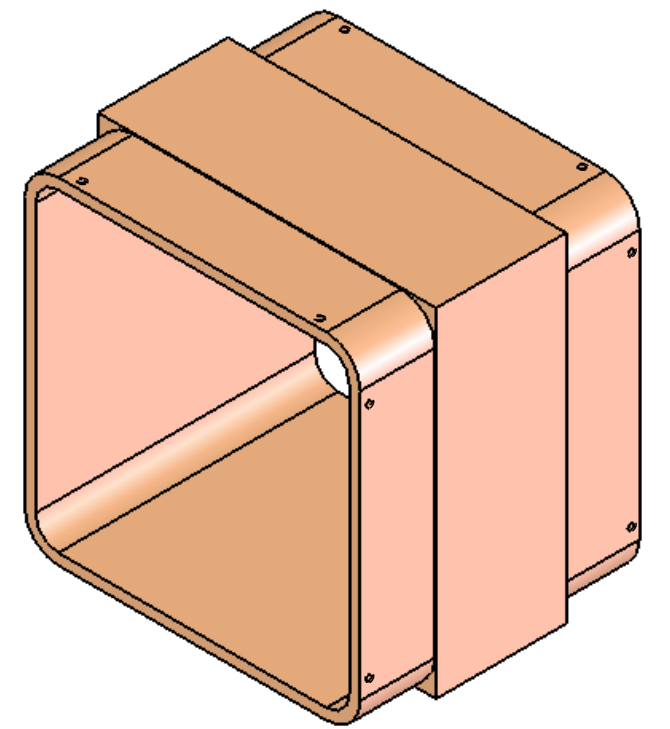


REVISIONS				
ZONE	REV.	DESCRIPTION	DATE	APPROVED
	0	INITIAL RELEASE.	04/02/07	JCW
	1	ADDED SQUARE MIDDLE FEATURE AND CHAMFER, AND CHANGED DIMENSIONS TO REFLECT AS BUILT PART.	05/14/07	SCP

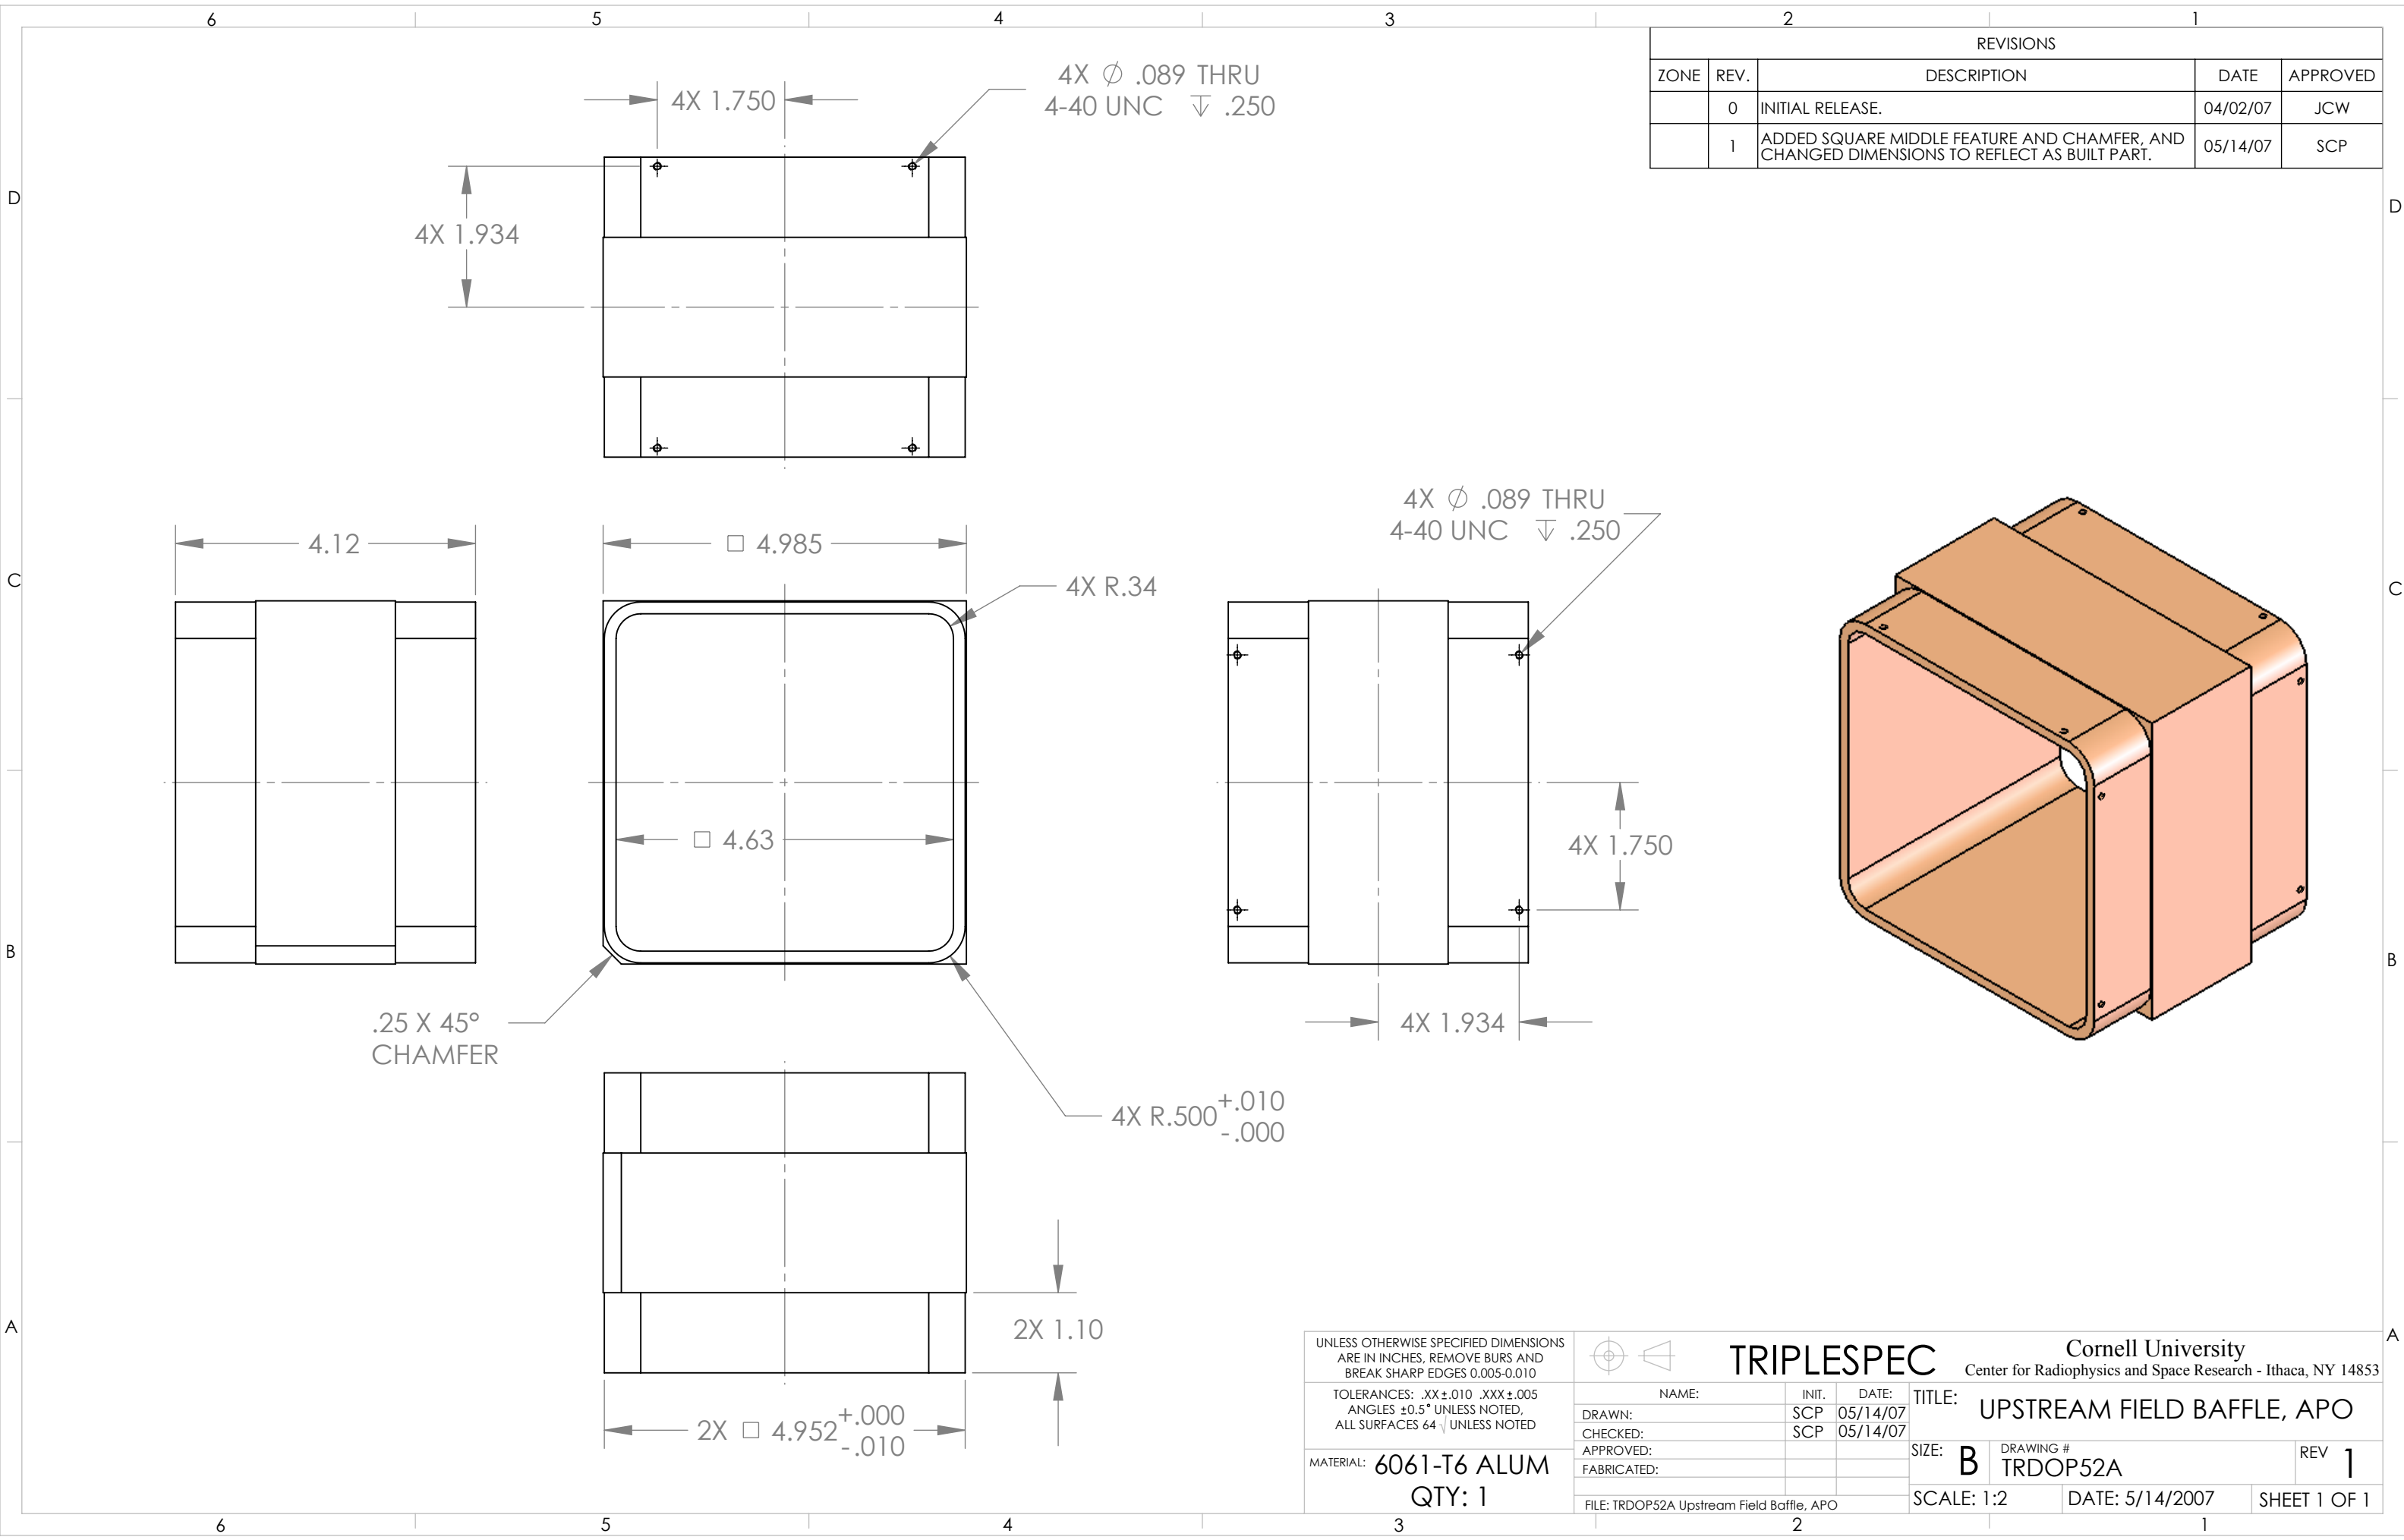

UNLESS OTHERWISE SPECIFIED DIMENSIONS ARE IN INCHES, REMOVE BURS AND BREAK SHARP EDGES 0.005-0.010

TOLERANCES: .XX ± .010 .XXX ± .005
ANGLES ± 0.5° UNLESS NOTED,
ALL SURFACES 64 UNLESS NOTED

MATERIAL: 6061-T6 ALUM
QTY: 1

TRIPLESPEC

Cornell University
Center for Radiophysics and Space Research - Ithaca, NY 14853

NAME:	INIT.	DATE:	TITLE:
DRAWN:	SCP	05/14/07	UPSTREAM FIELD BAFFLE, APO
CHECKED:	SCP	05/14/07	SIZE: B
APPROVED:			DRAWING # TRDOP52A
FABRICATED:			REV 1

FILE: TRDOP52A Upstream Field Baffle, APO

SCALE: 1:2

DATE: 5/14/2007

SHEET 1 OF 1